
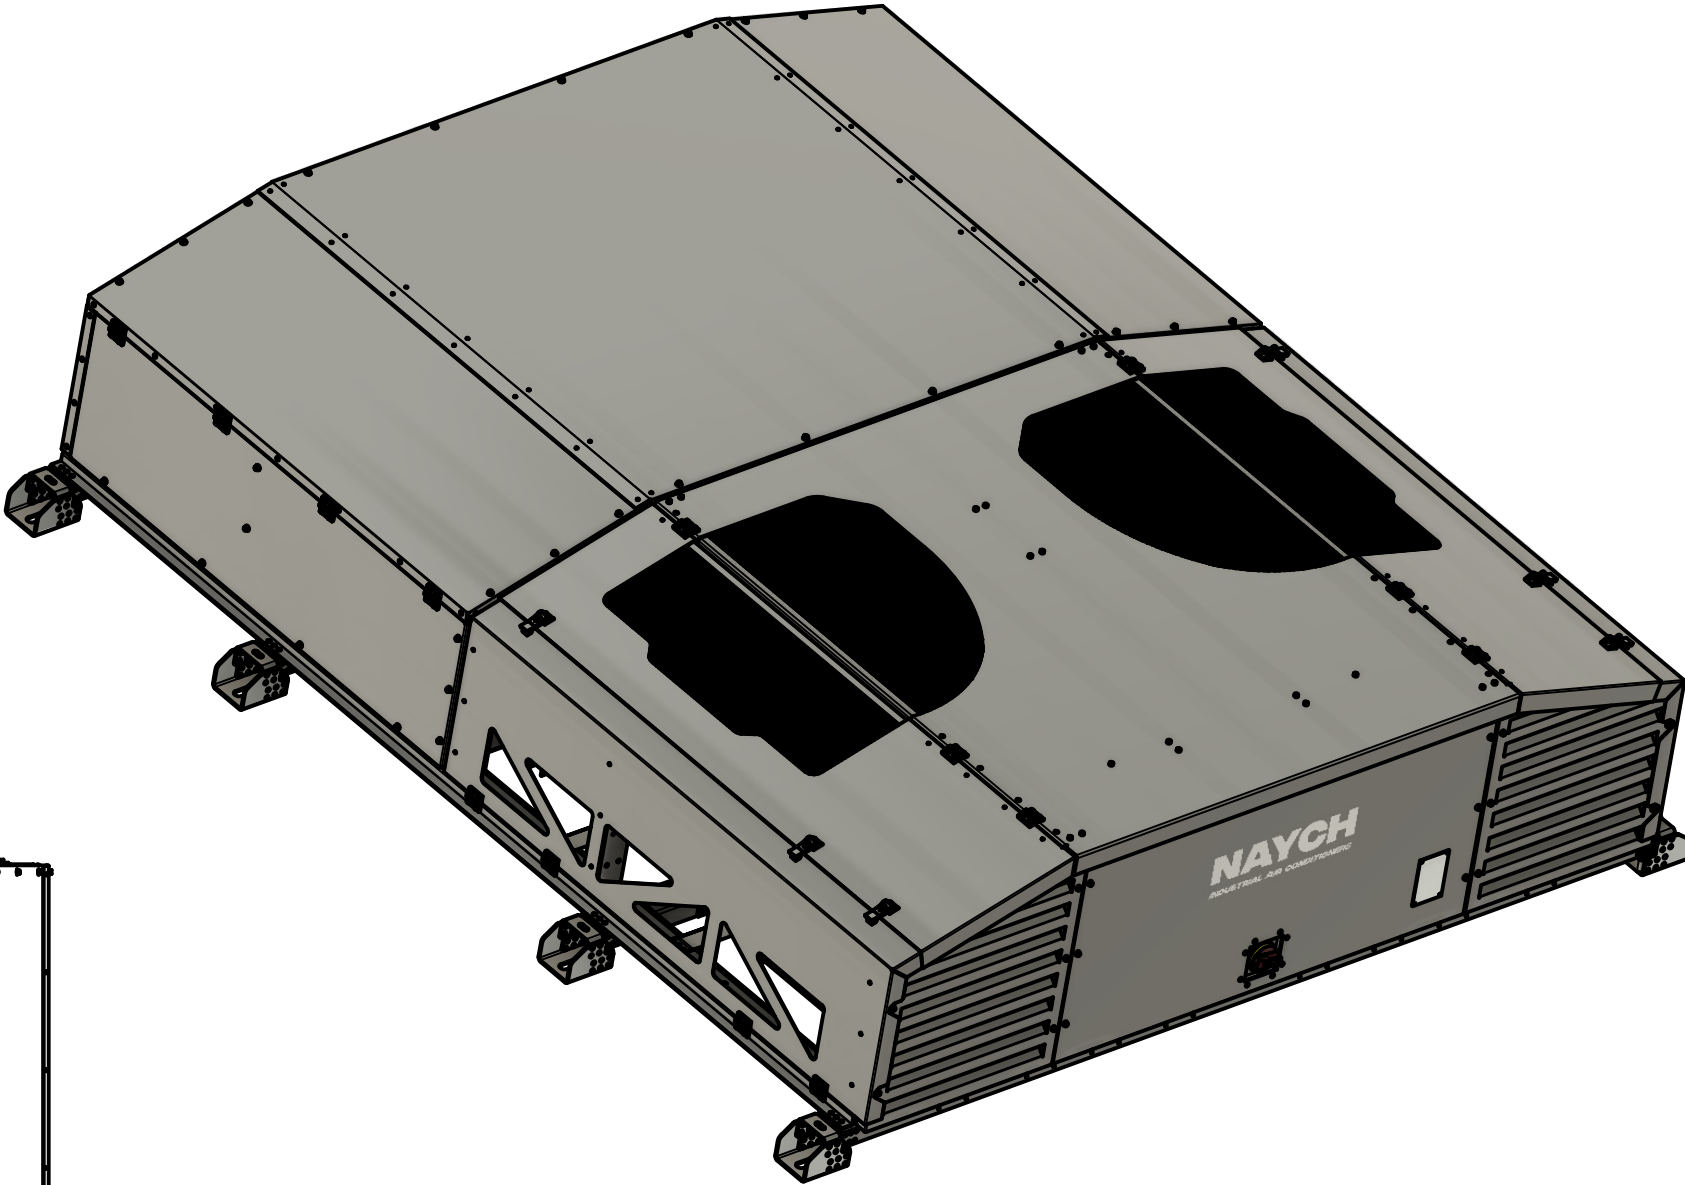
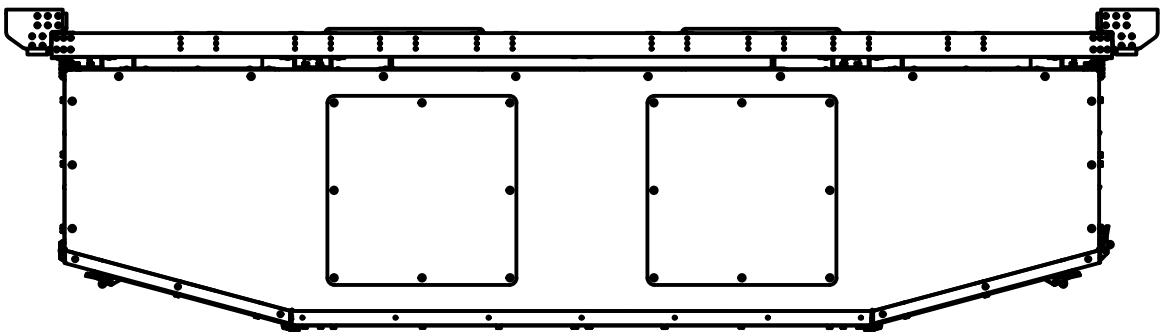
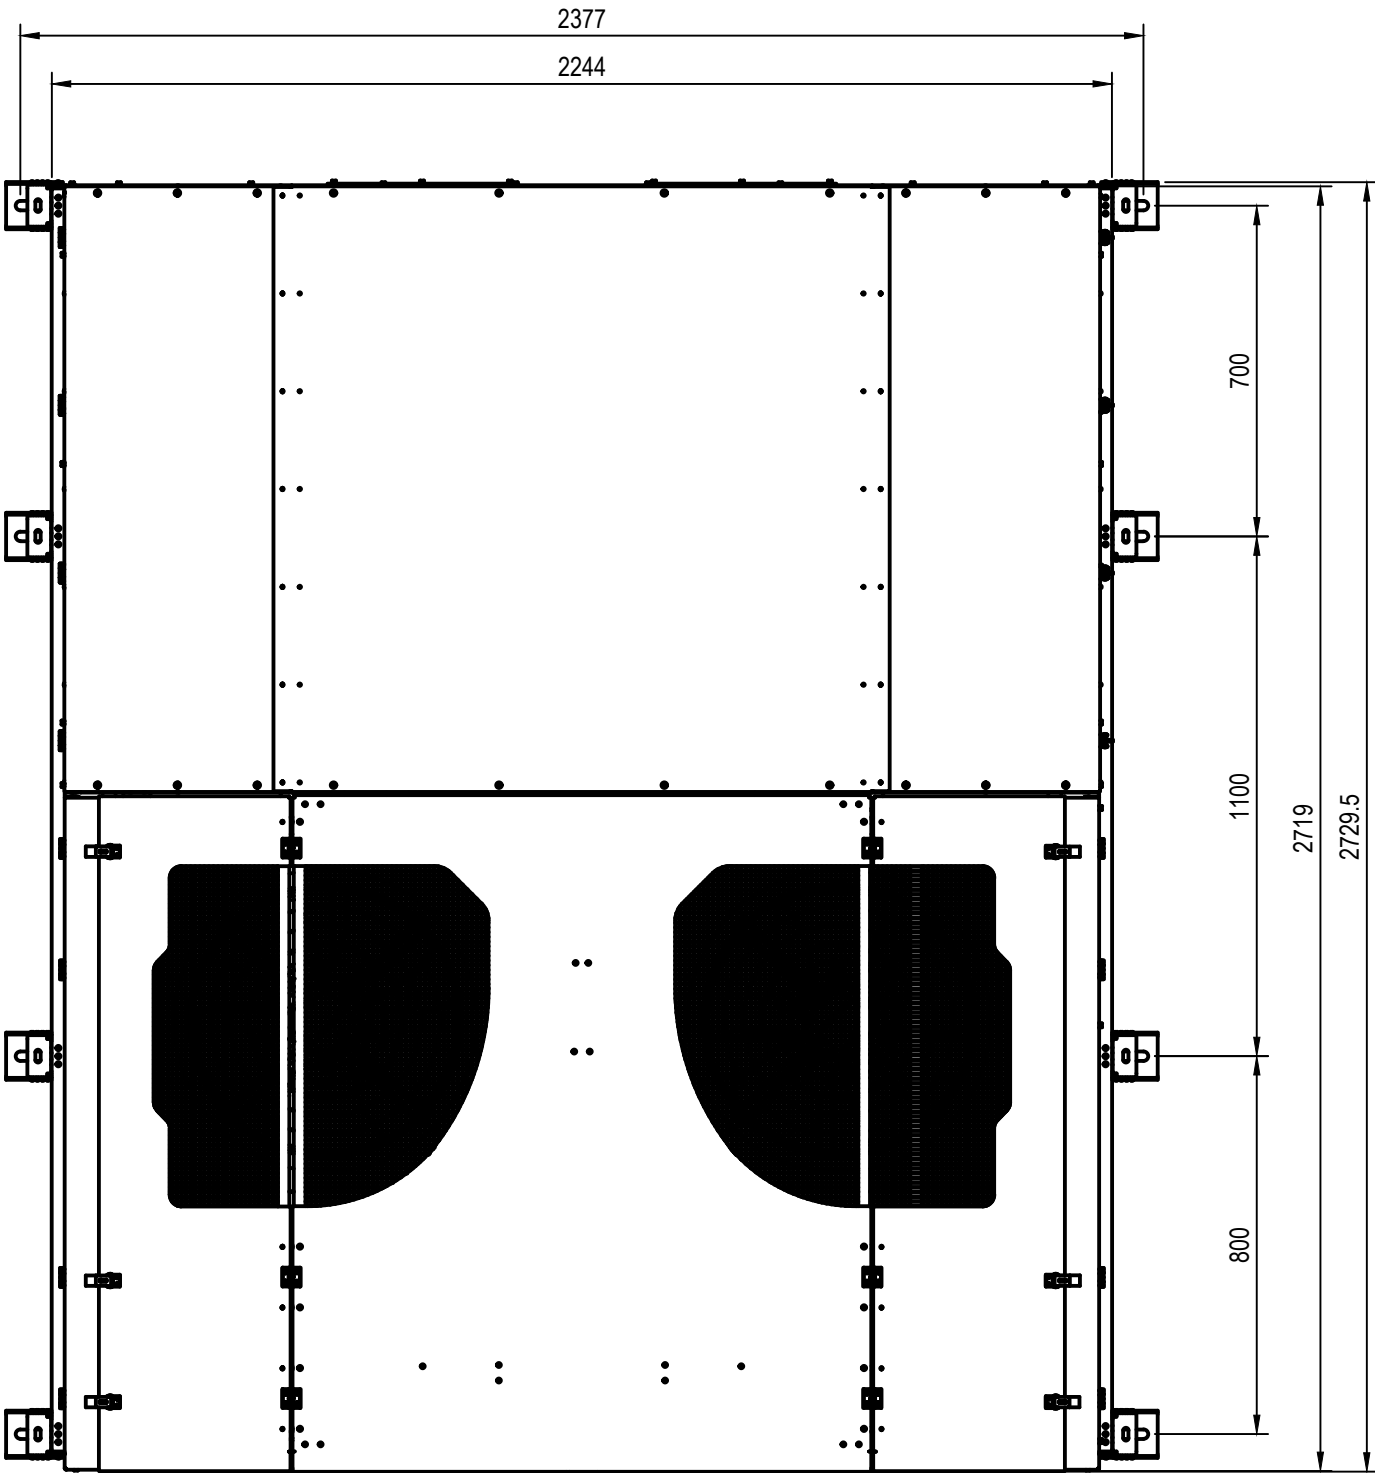


Confidentiality and Intellectual Property Protection Notice

The enclosed industrial drawings are the exclusive property of NAYCH SAS and its subsidiaries and are strictly confidential. They are protected by current intellectual property and copyright laws. Any reproduction, distribution, modification, dissemination or exploitation of these plans, in whole or in part, without the prior written authorization of NAYCH SAS, is strictly forbidden.

Any unauthorized use of these documents will result in legal action in accordance with applicable legal provisions. NAYCH SAS reserves the right to claim damages for any infringement of its intellectual property rights.

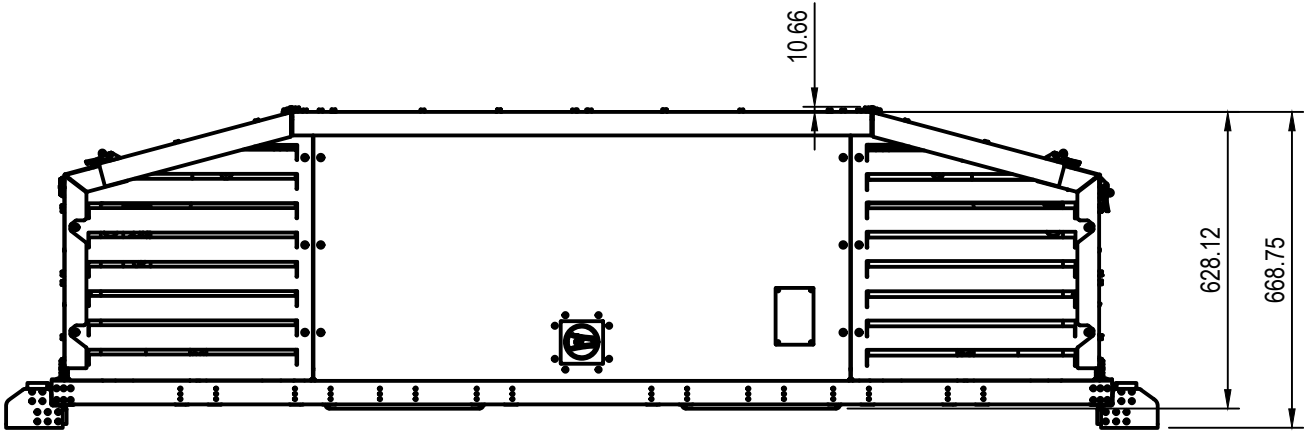

THE PRODUCTS CONCERNED ARE :

RTX07-400-STD-A1
RTX08-400-STD-A1
RTX10-400-STD-A1
RTX12-400-STD-A1
RTX06-400-STD-A1
RTX08-400-WCC-A1
RTX10-400-WCC-A1
RTX12-400-WCC-A1
RTX18-400-WCC-A1
RTX20-400-WCC-A1

RTX07-440-STD-A1
RTX08-440-STD-A1
RTX10-440-STD-A1
RTX12-440-STD-A1
RTX16-440-STD-A1
RTX08-440-WCC-A1
RTX10-400-WCC-A1
RTX12-400-WCC-A1
RTX18-400-WCC-A1

WEIGHT SPREAD OVER 8 FEET IS 850 KG

If not mentioned, dimensions are in millimeters.
No tolerance on axis-to-axis measurements
Maximum admissible tolerance is 0,25mm only if there is no assembly constraints.

Dept. PROD	Technical reference RTX HVAC	Created by NTS 27/11/2024	Approved by STN / JAB
NAYCH INDUSTRIAL AIR CONDITIONERS NAYCH TECHNOLOGIES SAS 99, avenue Achille Peretti 92200 NEUILLY SUR SEINE - FRANCE contact@naych.fr		Document type EXD	Document status AS BUILT
		Title RTX ISO DIMENSIONAL	DWG No. RTX_EXD21_A_E
		Rev. A	Date of issue 6/11/2024
		Sheet 1/1	